


Attachment A

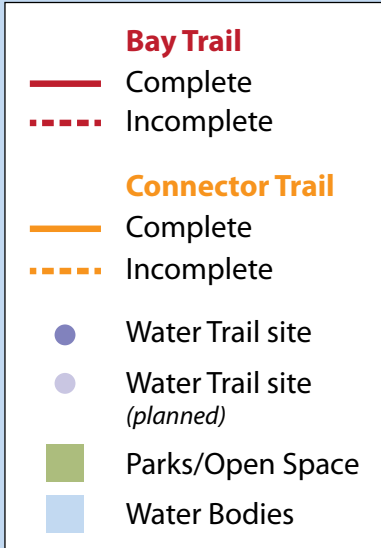

Blue Line -
Existing Bay
Trail to North
Shore

Potential Rerouting of Richmond Bay Trail

February 8, 2021

Green Line -
proposed new
alignment for Bay
Trail on Chevron
side of Parkway

Red Line - existing
Bay Trail
through homeless
encampment

Proposed
Chevron
Hydrogen Fill
Station -
Hensley at
Richmond
Parkway

Richmond Parkway

Hensley Avenue

Blue Line -
Existing
Bay Trail to
Garrard

Google

